

NOTES:


1. THE PRODUCT SHOWN IS DESIGNED TO COMPLY WITH THE 2004 FLORIDA BUILDING CODE, MIAMI DADE COUNTY REQUIREMENTS, AND THE INTERNATIONAL BUILDING CODE.
2. THE PANELS SHOWN IS 16mm THICK WITH AN "X BRACED" PROFILE. IT IS INTENDED FOR DIRECT INSTALLATION AS SHOWN HEREIN.
3. THE DIMENSIONS SHOWN ON THIS SHEET REPRESENT THE MAXIMUM ALLOWABLE HEIGHT AND WIDTH OF THE PANELS AS INSTALLED.
4. THIS SYSTEM IS NOT INTENDED FOR OPENINGS LARGER THAN 42" x 90". SECURED SHEETS MUST OVERLAP SUCH OPENINGS A MINIMUM OF 3" ALONG ALL FOUR EDGES.
5. PANELS MUST BE INSTALLED ACCORDING TO THE MANUFACTURER'S RECOMMENDATIONS (AS PRESENTED IN THIS DOCUMENT). FAILURE TO DO SO MAY RESULT IN PRODUCT FAILURE AND ADDITIONAL PROPERTY DAMAGE.
6. NOTE THAT ONLY THE LABELED SIDE OF THE PANEL IS UV PROTECTED AND THAT THIS SIDE SHOULD FACE OUTWARDS. MAKE NOTE OF THIS SIDE WHEN REMOVING THE PROTECTIVE FILM.

TABLE OF CONTENTS	
SHEET	DESCRIPTION
1	GENERAL NOTES AND DIMENSIONS
2	FASTENER PLACEMENT DETAILS
3	HARDWARE DETAILS
4	WINDOW INSTALLATION DETAILS

PALRAM AMERICAS INC. ARCADIA WEST INDUSTRIAL PARK 8735 OCHMERE CIRCLE KUTZTOWN, PA 15530 PHONE: 610-265-9518 FAX: 610-265-2659		TITLE: 16mm SUNLITE X-LITE HURRICANE PANEL INSTALLATION DETAILS AND NOTES DRAWING NUMBER: SCALE: DRAWN BY: SHEET: 1 OF 4
--	--	---


REV.	DATE	BY
0	10/24/06	DHD

Test sample complies with these details. Deviations are noted.
 Report# 68911.01
 Date 12/29/06 Tech SDS

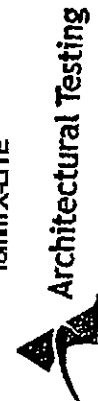

EXTERIOR ELEVATION
16mm X-LITE


FASTENERS ARE INSTALLED
6" MAX FROM CORNER

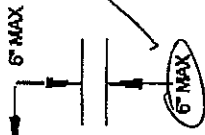

FASTENER SPACING
AROUND THE
PERIMETER
SHOULD NOT
EXCEED 12"

NOTES:

1. FASTENERS SHOULD BE PLACED 6" MAXIMUM FROM EACH CORNER AND 2" MINIMUM ALONG PANEL EDGES.
2. FASTENERS ARE TO BE SPACED 12" MAXIMUM ALONG THE VERTICAL AND HORIZONTAL EDGES OF THE INSTALLATION.
3. ONLY RECOMMENDED FASTENERS AND ASSOCIATED HARDWARE ARE PERMISSIBLE FOR USE ON THIS INSTALLATION.

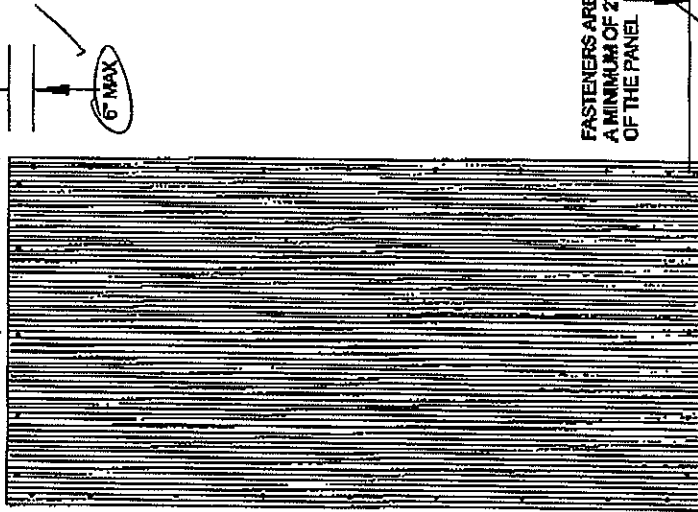

FASTENERS ARE TO BE INSTALLED
A MINIMUM OF 2" FROM THE EDGE
OF THE PANEL

2" MIN




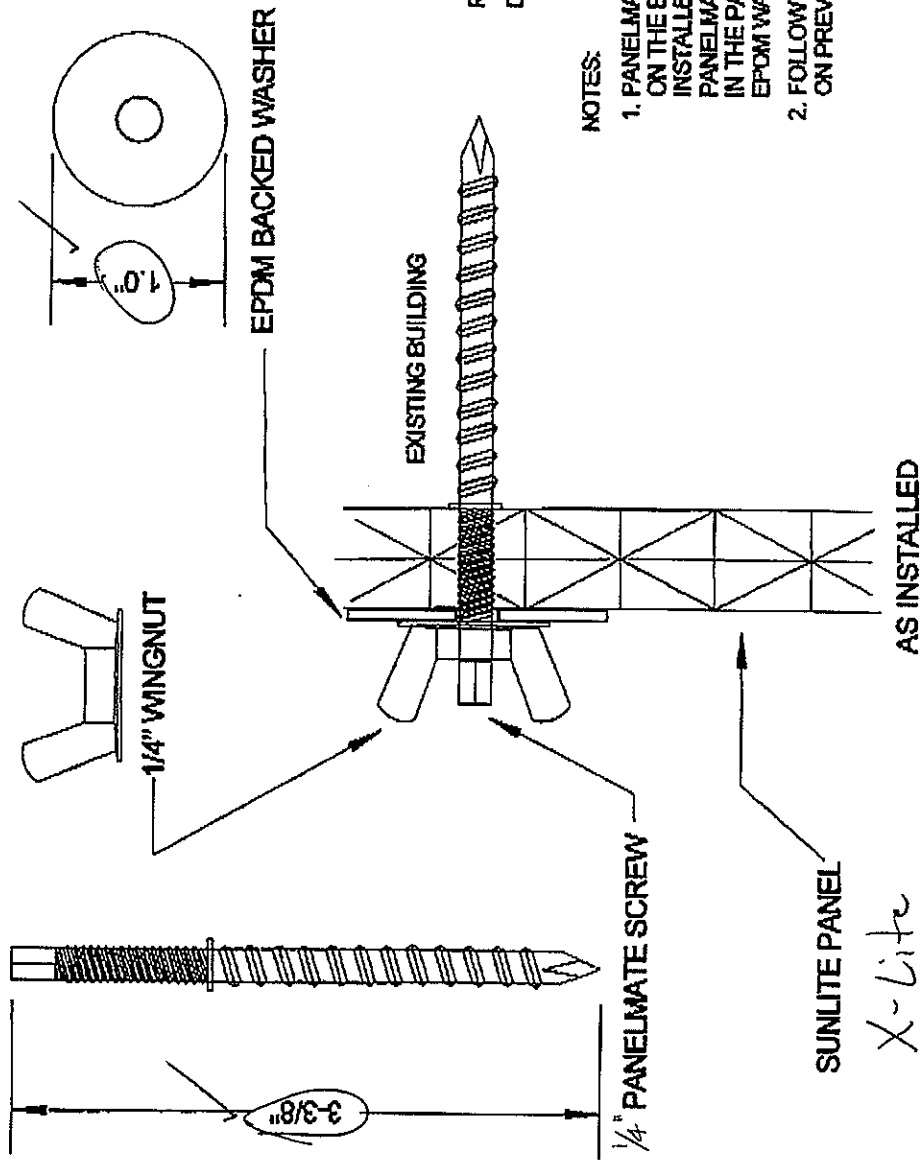
Architectural Testing

Test sample complies with these details.
Deviations are noted.

Report# 68911.01

Date 12/29/06 Tech SDS

PALRAM AMERICAS INC. ARCADIA WEST INDUSTRIAL PARK 9756 COMMERCE CIRCLE KUTZTOWN, PA 17530 PHONE: 610-285-9918 FAX: 610-285-2859		TITLE: 16mm SUNLITE X-LITE HURRICANE PANEL INSTALLATION DETAILS AND NOTES DRAWING NUMBER: SCALE: DRAWN BY: SHEET: 2 OF 4						
		<table border="1"> <tr> <td>REV.</td> <td>DATE</td> <td>BY</td> </tr> <tr> <td>0</td> <td>10/24/06</td> <td>DHO</td> </tr> </table>	REV.	DATE	BY	0	10/24/06	DHO
REV.	DATE	BY						
0	10/24/06	DHO						



Test sample complies with these details.
Deviations are noted.

Report# 68911.01
Date 12/27/06 Tech SBS

NOTES:

1. PANELMATE SCREWS ARE PERMANENT INSTALLED ON THE EXISTING STRUCTURE. PANELS ARE INSTALLED BY PLACING THE SHEET ONTO THE PANELMATE SCREWS THROUGH PREDRILLED HOLES IN THE PANEL. THE PANEL IS SECURED WITH AN EPDM WASHER AND 1/4" WINGNUT AS SHOWN.
2. FOLLOW THE FASTENING PATTERN AS SHOWN ON PREVIOUS DETAILS.

PALRAM AMERICAS INC.

ARCADIA WEST INDUSTRIAL PARK
5735 COMMERCE CIRCLE
KUTZTOWN, PA 19330
PHONE: 610-285-8918
FAX: 610-285-2859



TITLE: 16mm SUNLITE X-LITE HURRICANE PANEL


INSTALLATION DETAILS AND NOTES

DRAWING NUMBER: SCALE: SHEET: 3 OF 4

REV.	DATE	BY
1	11/28/06	DHO
0	10/24/06	DHO

SUNLITE PANEL
X-Lite

AS INSTALLED

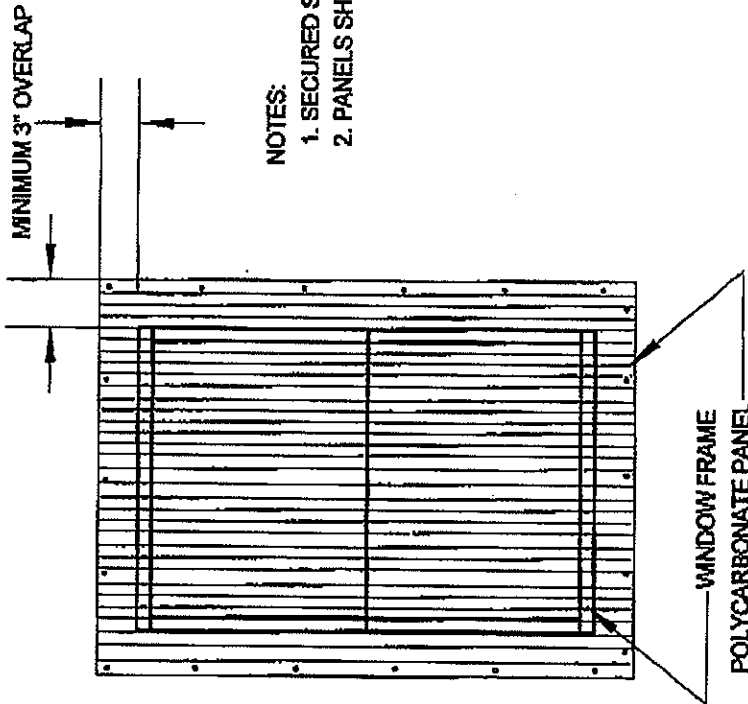

NOTES:

1. SECURED SHEETS MUST OVERLAP WINDOW FRAME BY AT LEAST 3"
2. PANELS SHOULD EXTEND AT LEAST 1" BEYOND THE WINDOW PANE.

PALRAM AMERICAS INC.		TITLE: 16mm SUNLITE X-LITE HURRICANE PANEL INSTALLATION DETAILS AND NOTES	
ARCADIA WEST INDUSTRIAL PARK 9735 COMMERCE CIRCLE RUTZTOWN, PA 19350		DRAWING NUMBER:	SCALE:
PHONE: 610-386-9916 FAX: 610-285-2859		DRAWN BY:	SHEET: 4 OF 4

REV.	DATE	BY
0	10/25/06	DHO